



Liquor and Cannabis Regulation Branch  
 400-645 Tye Road, Victoria, BC V9A 6X5  
 Mail: PO Box 9292 Stn Provincial Govt, Victoria, BC V8W 9J8  
 Phone: 1 866 209-2111 Fax: 250-952-7066

# TEMPORARY CHANGE TO A LIQUOR LICENCE FOOD PRIMARY, LIQUOR PRIMARY, LIQUOR PRIMARY CLUBS & MANUFACTURERS ENDORSEMENTS

Liquor and Cannabis Regulation Form LCRB023

**Instructions:**

Complete all applicable fields and then submit with payment as outlined in Part 11 of this application form. You may complete this form online and then print. If you have any questions about this application, call the Liquor and Cannabis Regulation Branch (LCRB) toll-free at: 1 866 209-2111. A complete application including the supporting documents must be submitted a minimum of three (3) weeks in advance of your event(s); otherwise your application will not be accepted and will be returned to you with the fees.

Applications requesting discretion to policy (see Part 9) must be submitted a minimum of two (2) months prior to your proposed event; otherwise your application will not be accepted and will be returned to you with the fees. LCRB forms and supporting materials referred to in this document can be found at: [www.gov.bc.ca/liquorregulationandlicensing](http://www.gov.bc.ca/liquorregulationandlicensing)

**Licensee Information**

Office use only

Licence number:

Job No. (C3-LIC)

Type:  Food Primary  Liquor Primary  Liquor Primary Club  Winery

Licensee name (as shown on licence):

Establishment name (as shown on licence):

Establishment Address:      
Street City Province Postal Code

Contact Name:  Title/Position:   
(last / first / middle)

Business Tel with area code:  Business Fax with area code:

Business e-mail:

Business Mail address (if different from above):      
Street City Province Postal Code

Note: An authorized signing authority of a licensee can appoint a representative to interact with the branch on their behalf by completing form LCRB101 Add, Change or Remove Licensee Representative

**Part 1: Temporary Change Requested**

Please check the appropriate boxes below. You may complete more than one change section on this form as long as the changes are for the same licence number. **Note:** Categories noted by an asterisk (\*) require local government/First Nations comment.

Type of change requested	Complete Sections
<input type="checkbox"/> <b>Temporary change to hours of sale</b> • Liquor-Primary and Liquor-Primary Club licences, and manufacturer lounge or special event endorsements – any hours changes* • Food-Primary licences – requests for hours of sale later than midnight* • Food-Primary licences – requests for hours of sale before midnight	1, 2, 3, 10, 11, 12 1, 2, 3, 10, 11, 12 1, 2, 3, 10, 11
<input type="checkbox"/> <b>Temporary patron participation entertainment endorsement*</b> Food-Primary licences only	1, 2, 4, 10, 11, 12
<input type="checkbox"/> <b>Temporary extension of licensed area</b> Food-Primary licences only	1, 2, 5, 10, 11
<input checked="" type="checkbox"/> <b>Temporary extension of licensed area*</b> Liquor-Primary and Liquor-Primary Club licences, and manufacturer lounge or special event endorsements.	1, 2, 6, 10, 11, 12
<input type="checkbox"/> <b>Temporary location change*</b> Liquor-Primary and Liquor-Primary Club licences only (no increase in patron or person capacity)	1, 2, 7, 10, 11, 12
<input type="checkbox"/> <b>Temporary location change</b> Food-Primary licences only (no increase in patron or person capacity)	1, 2, 8, 10, 11
<input type="checkbox"/> <b>Other</b> Applies to all change requests other than these listed above	1, 2, 9, 10, 11

F.V.R.D. BLDG. DEPT

FEB 12 2020

**Part 2: Reason Temporary Change is Requested**

Describe event details including who is holding the event, the hours of the event and its purpose:

Jim Maclean Memorial Change is Requested  
 Saturday, June 13, 2020 430-11pm Fundraiser for charity TBD Hosted by the Sasquatch Inn  
 Current seating capacity is 144 See Attachment - wish to make extended area licensed for 100

Sasquatch In Annual Motorcycle Show and Shine  
 Sunday, July 26, 2020 12-5pm Hosted by the Sasquatch Inn Fundraiser for Zajac Ranch  
 Current seating capacity is 144 See attachment - wish to make extended area licensed for 1000

Wine Education & Tasting  
 Friday, May 22, 2020 6-10pm Hosted by the Sasquatch Inn  
 Current seating capacity is 144 See attachment - wish to make extended area licensed for 30

Brewmasters Dinner  
 Friday, June 26, 2020 6-10 Hosted by the Sasquatch Inn  
 Current seating capacity is 144 See attachment - wish to make the extended licensed area for 30

Wespac Electrical Dinner  
 Saturday, Sept 12, 2020 Hosted by the Sasquatch Inn  
 Staff and customer appreciation dinner of Wepac Electrical  
 Current seating capacity is 144 - wish to make the extended licensed area for 40

Date(s) from: (mm/dd/yy)  To: (mm/dd/yy)  (inclusive)

**Part 3: Temporary Change to Hours of Sale**

Fee: \$330

Liquor-Primary and Liquor-Primary Club licences, and manufacturer lounge or special event endorsements – any hours changes\*

Fee: \$330

Food-Primary licences – requests for hours of sale later than midnight\*

Fee: \$110

Food-Primary licences – requests for hours of sale before midnight (local government/First Nations comment not required)

**\*Note:** These categories (\*) require local government/First Nation comment.

Licensees may apply for a temporary change in hours of sale for a limited period, subject to any restrictions within the Liquor Control and Licensing Act, Regulations, branch policies and/or original terms and conditions of licensing.

See Part 12 for more information on obtaining local government/First Nations comment.

Please provide the following information:

Current hours of sale:

	Monday	Tuesday	Wednesday	Thursday	Friday	Saturday	Sunday
Open	<input type="text"/>	<input type="text"/>	<input type="text"/>	<input type="text"/>	<input type="text"/>	<input type="text"/>	<input type="text"/>
Closed	<input type="text"/>	<input type="text"/>	<input type="text"/>	<input type="text"/>	<input type="text"/>	<input type="text"/>	<input type="text"/>

Requested hours of sale: (Maximum hours permitted by regulation are between 9:00 am to 4:00 am of the same business day)

	Monday	Tuesday	Wednesday	Thursday	Friday	Saturday	Sunday
Open	<input type="text"/>	<input type="text"/>	<input type="text"/>	<input type="text"/>	<input type="text"/>	<input type="text"/>	<input type="text"/>
Closed	<input type="text"/>	<input type="text"/>	<input type="text"/>	<input type="text"/>	<input type="text"/>	<input type="text"/>	<input type="text"/>

---

**Part 4: Temporary Patron Participation Entertainment Endorsement**

Fee: \$330

(Food-Primary licences only)

Licensees may apply for a patron participation entertainment endorsement for a limited period, subject to any restrictions within the Liquor Control and Licensing Act, Regulations, branch policies and/or original terms and conditions of licensing.

**Note:** This application process requires comment from your local government/First Nation. See Part 12 for more information on this process.

Describe the type of entertainment you are requesting:

Patron participation must end by midnight unless approved by LCRB and local government/First Nations. There are restrictions related to forms of entertainment, sound systems, etc. If you are uncertain about any of the details of your proposal, please consult with licensing staff at LCRB in Victoria (see contact information in Part 11).

---

**Part 5: Temporary Extension of Licensed Area (food-primary licences only)**

Fee: \$110

This change enables licensees to apply for a temporary extension of their establishment's licensed areas for a limited period, subject to any restrictions within the *Liquor Control and Licensing Act*, Regulations, branch policies and/or original terms and conditions of licensing. Approval of this temporary change request permits the licensee to operate only at the capacity on the face of their current licence plus the capacity of the extension area. If in doubt, consult with licensing staff at LCRB in Victoria (see Part 11 for contact info). This application process does not require comment from your local government/First Nation.

Please provide the following information and documents:

- Current total capacity, including patios (as shown on licence);
- Identify the area (person/patron as shown on licence) to be extended;
- Floor plan of the extended area showing how perimeter is defined, dimensions and its physical relationship to existing licensed areas:
  - Floor plan must have occupant load of the extended area marked/stamped on the plans by provincial fire or building authority (or designate) where the extension is indoors or within a permanent structure.
  - Provide proposed capacity of extended area if extension is outside; and
- Where the extension area is not on property owned or controlled by the licensee, provide written approval for such use from the property owner.

---

**Part 6: Temporary Extension of Licensed Area**

Fee: \$330

(liquor-primary, liquor-primary club licence and manufacturer lounge and special events endorsements only)

Licensees may apply for a temporary extension of their licensed areas for a limited period, subject to any restrictions within the *Liquor Control and Licensing Act*, Regulations, branch policies and /or original terms and conditions of licensing. Approval of this temporary change request permits the licensee to operate at the capacity on the face of their current licence plus the capacity of the extension area.

**Note:** This application process requires comment from your local government/First Nation. See Part 12 for more information on this process.

Please provide the following information and documents:

- Current total capacity, including patios (as shown on licence);
- Identify the area(s) to be extended;
- Floor plan of the extended area(s) showing how perimeter is defined, dimensions and its physical relationship to existing licensed areas:
  - Floor plan must have occupant load of the extended area marked/stamped on the plans by provincial fire or building authority (or designate) where the extension is indoors or within a permanent structure.
  - Provide proposed person capacity of extended area(s) if extension is outside; and
- Where the proposed area is not on property owned or controlled by the licensee, provide written approval for such use from the property owner.

**Part 7: Temporary Location Change (liquor-primary and liquor-primary club licences only)**

Fee: \$330

(no increase in patron or person capacity)

Licensees may apply for a temporary change of location of one or more licensed areas in their establishment, to accommodate special events but this change permits no increase in licensed capacity. Proposed changes must comply with occupant load limitations.

**Note:** This application process requires comment from your local government/First Nation. See Part 12 for more information on this process.

Current area capacities, as shown on licence:

Area #1  Area #2  Area #3  Area #4  Patio #1  Patio #2

Proposed temporary changes in capacity (no increase in total capacity permitted):

Area #1  Area #2  Area #3  Area #4  Patio #1  Patio #2

Please attach the following documents:

- Floor plan of the proposed area(s) showing how perimeter is defined, dimensions and its physical relationship to existing licensed areas.
  - Floor plan must have occupant load marked/stamped on the plans by provincial fire or building authority (or designate), where the extension is indoors or within a permanent structure.
  - Provide proposed capacity of the new area if outdoors.
- Where the proposed area is not on property owned or controlled by the licensee, provide written approval for such use from the property owner.

**Part 8: Temporary Location Change (food-primary licences only)**

Fee: \$110

(no increase in patron or person capacity)

Licensees may apply for a temporary change of location of one or more licensed areas in their establishment, to accommodate special events but this change permits no increase in licensed capacity. Proposed changes must comply with occupant load limitations.

**Note:** This application process does not require comment from your local government/First Nation.

Current area capacities, as shown on licence:

Area #1  Area #2  Area #3  Area #4  Interior lounge

Patio #1  Patio #2

Proposed temporary changes in capacity (no increase in total capacity permitted):

Area #1  Area #2  Area #3  Area #4  Interior lounge

Patio #1  Patio #2

Please attach the following documents:

For food-primary licences:

- Floor plan of the proposed area showing how perimeter is defined, dimensions and its physical relationship to existing licensed areas.
  - Floor plan must have occupant load marked/stamped on the plans by provincial building or fire authority (or designate), where the extension is indoors or within a permanent structure.
  - Provide proposed capacity of the new area if outdoors.
- Where the proposed area is not on property owned or controlled by the licensee, provide written approval for such use from the property owner.

**Part 9: Other**

Fee: \$110 for each request

Complete this section if you are requesting a change other than those listed in Part 1, page 1.

Describe your request in detail, using additional pages if required.

If your request requires an exercise of discretion: provide a written submission detailing why a request for discretion should be approved. All documentation to support your request for discretion must be submitted together in one package; the branch will not consider additional materials submitted after a completed application is received. For more information see your licence specific terms and conditions. Requests for discretion should be submitted at least two months prior to the proposed event.

Date(s) from:  To:  (inclusive) Time(s):   
(mm/dd/yy) (mm/dd/yy)

**Part 10: Declaration**

Section 57(1)(c) of the *Liquor Control and Licensing Act* states: "A person commits an offence if the person (c) provides false or misleading information in the following circumstances: (i) when making an application referred to in section 12; (ii) when making a report or when required and as specified by the general manager under section 59".

As the licensee or authorized signatory of the licensee, I understand and affirm that all of the information provided is true and complete.

Signature:   
Authorized signatory of the licensee

Name:  Position:  Date:   
(last / first / middle) (if not an individual) (Day/Month/Year)

Note: An agent, lawyer or third party operator may not sign the declaration on behalf of the licensee.

This form should be signed by an individual with the authority to bind the applicant. The Branch relies on the licensee to ensure that the individual who signs this form is authorized to do so. Typically, an appropriate individual will be as follows:

- If the licensee is an individual or sole proprietor, the individual himself/herself
- If the licensee is a corporation, a duly authorized signatory who will usually be an officer or, in some cases, a director
- If the licensee is a general partnership, one of the partners
- If the licensee is a limited partnership, the general partner of the partnership
- If the licensee is a society, then a director or a senior manager (as defined in the *Societies Act*)

If an authorized signatory has completed the *Add, Change or Remove Licensee Representative* form (LCRB101) and they have specifically permitted a licensee representative to sign this form on the licensee's behalf, the branch will accept the licensee representative's signature.

**Part 11: Application Fees - Payment Options**

Total Fee Submitted: \$

In accordance with Payment Card Industry Standards, the branch is no longer able to accept credit card information via email.

Payment is by (check  one):

- Cheque, payable to Minister of Finance (if cheque is returned as non-sufficient funds, a \$30 fee will be charged)
- Money order, payable to Minister of Finance
- Credit card:  VISA  MasterCard  AMEX
- I am submitting my application by email and I will call with my credit card information. I will call Victoria Head Office at 250-952-5787 or 1-866-209-2111 and understand that no action can proceed with my application until the application fee is paid in full.
- I am submitting my application by fax or mail and have given my credit information in the space provided at the bottom of the page.

**Credit Card Information** (To be submitted by fax or mail only)

Name of cardholder (as it appears on card):   
Credit card number:  Expiry date:  /   
(Month) (Year)

Signature: \_\_\_\_\_

**Part 12: Local Government/First Nation Comments**

Objection

No objection

Comments:

\_\_\_\_\_  
\_\_\_\_\_  
\_\_\_\_\_  
\_\_\_\_\_  
\_\_\_\_\_  
\_\_\_\_\_  
\_\_\_\_\_  
\_\_\_\_\_  
\_\_\_\_\_

Name of Municipality/Regional District/First Nations:

Name (print) \_\_\_\_\_ Phone: \_\_\_\_\_

Title: \_\_\_\_\_ E-mail: \_\_\_\_\_

Signature: \_\_\_\_\_ Date: \_\_\_\_\_

**Part 13: What Happens Next?**

The temporary change application process:

1. If the requested temporary change(s) require local government/First Nation comment, the applicant must take the completed application form and all required documents to their local government/First Nation and request that the local government/First Nation complete and sign Part 12.
2. The applicant will submit the signed application, all required documents and application fee to the Victoria Head Office (LCRB).


**Note:** Applicants must ensure they submit their completed application a minimum of three (3) weeks (or two (2) months, if it's a request for discretion - see Part 9) before the proposed change. Otherwise, your application will not be accepted and will be returned to you.

3. The LCRB licensing staff will review the application package and advise the applicant by phone, mail or fax, of any information or documents required before the application can be processed.
4. LCRB licensing staff will request comments from the local liquor inspector.
5. If required, the local liquor inspector will work with the applicant on security and related issues.
6. LCRB licensing staff will review the comments from the local government/First Nation (if applicable) and local liquor inspector.
7. LCRB staff will contact the applicant by, fax or mail to let them know whether or not the change has been approved. The applicant will receive LCRB's decision in writing.

The information requested on this form is collected by the Liquor and Cannabis Regulation Branch under Section 26 (a) and (c) of the *Freedom of Information and Protection of Privacy Act* and will be used for the purpose of liquor licensing and compliance and enforcement matters in accordance with the *Liquor Control and Licensing Act*. Should you have any questions about the collection, use, or disclosure of personal information, please contact the Freedom of Information Officer at PO Box 9292 STN PROV GVT, Victoria, BC, V8W 9J8 or by phone toll free at 1-866-209-2111.

# Wine Education, Tasting, & Food Pairing

Black mark indicates two 20'x20' tents, they will be attached. The tent will have barricades around it for the event to ensure that no patrons veer outside the red line area. X marks the door we will be using. The tents in this plan will have security personel to monitor that the patrons stay inside the proper area as well as the waitress.

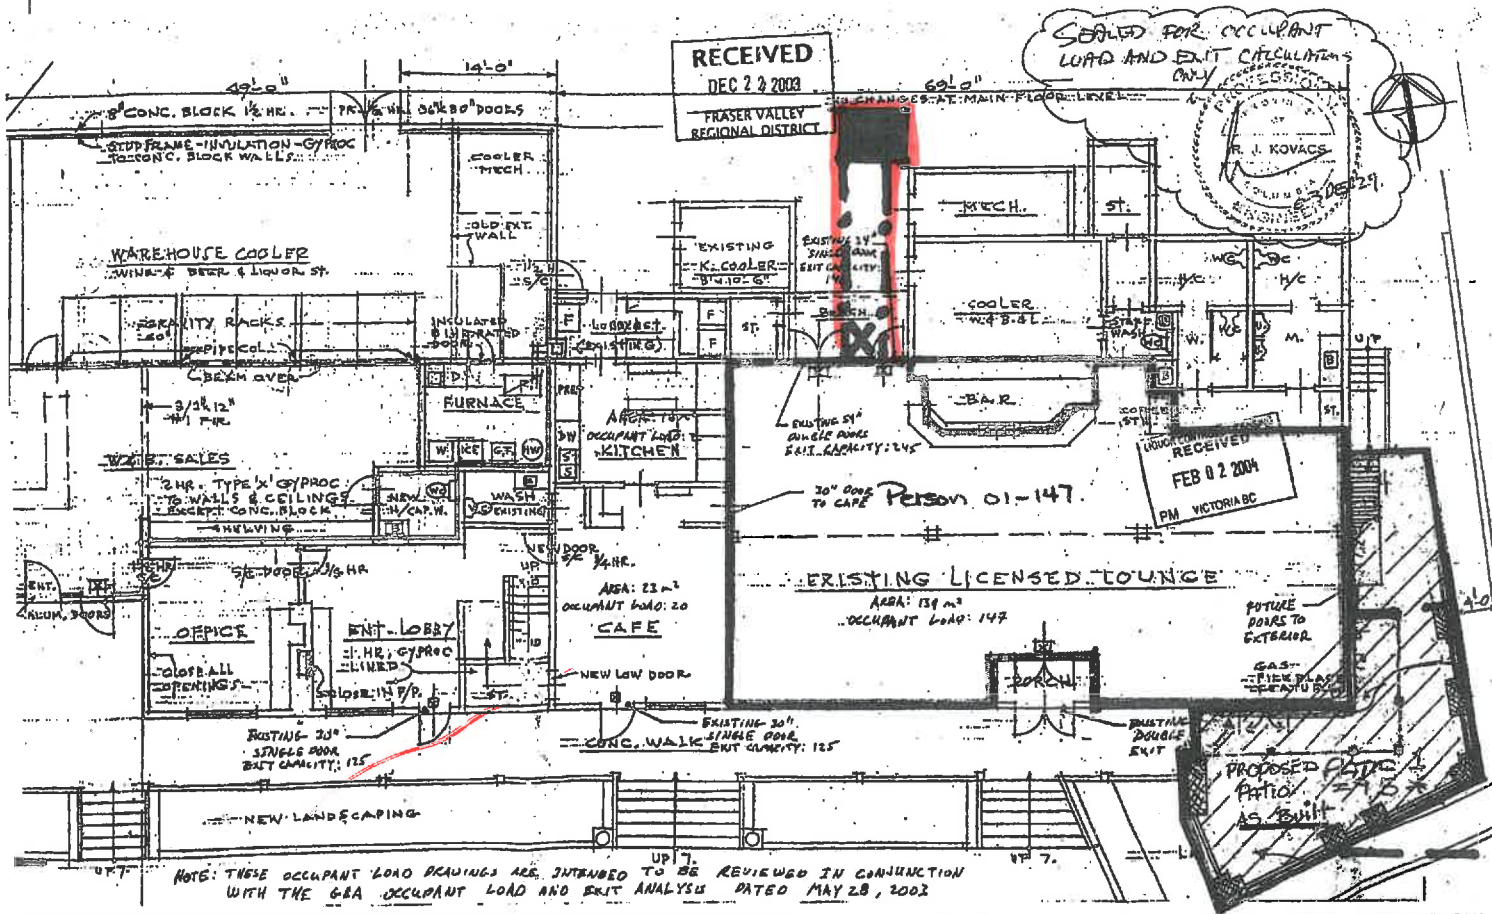

May 22, 2020

Occupant Load 30

Distance from Pub door to Tent is Approx 20'.

**G&A**  
GAGE-BABCOCK AND ASSOCIATES LTD.  
228 - 185 W. BROADWAY, VANCOUVER BC  
TEL: 732 3781 FAX: 732 1277  
email: f@gabcan.com, www.gabcan.com

SASQUATCH INN  
46001 LOUGHEED, HARRISON MILLS

GROUND FLOOR - PLAN VIEW

DATE: 03/12/09  
DRAWN: KL


CP. 1.17

# PARKING LOT



# GOLF TOURNAMENT

Black mark indicates two tents (30' x 20', 20' x 20'), they will be attached. The tents will have barricades around it for the event to ensure that no patrons veer outside the red line area. X marks the door we will be using. The tents in this plan will have security personnel to monitor that the patrons stay inside the proper area as well as the waitress.

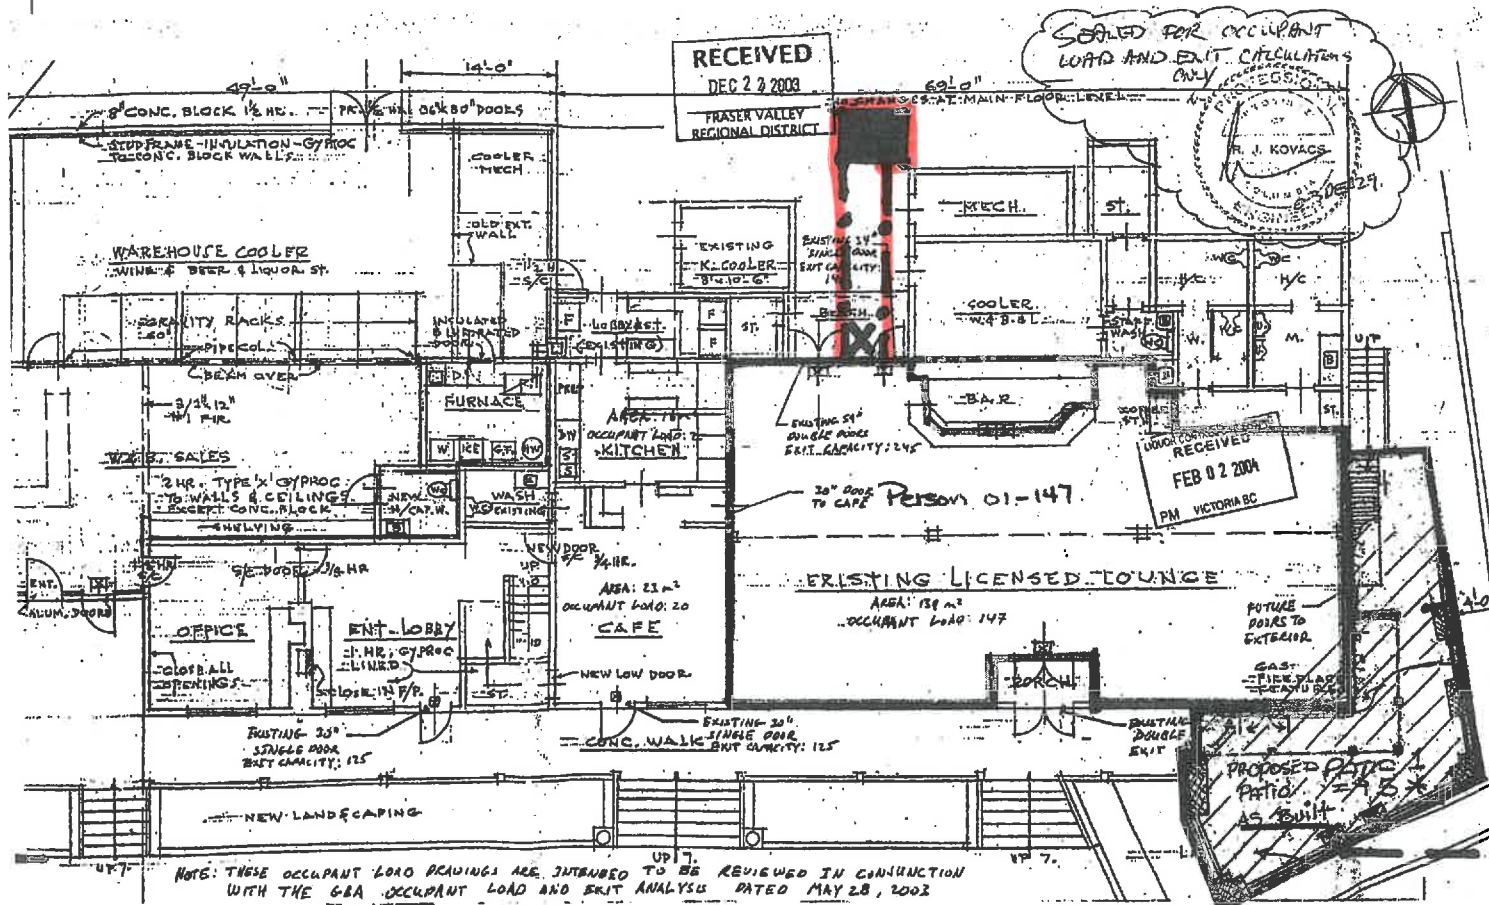

June 13, 2020

Occupant Load 100

Distance from Pub door to Tent is Approx 20'.

NOTE: THESE OCCUPANT LOAD DRAWINGS ARE INTENDED TO BE REVIEWED IN CONJUNCTION WITH THE GBA OCCUPANT LOAD AND EXIT ANALYSIS DATED MAY 28, 2003

**GBA** GAGE-BARCOCK AND ASSOCIATES LTD  
228 - 185 W. BROADWAY, VANCOUVER BC  
TEL 778 3781 FAX 778 1277  
email info@gbacan.com, www.gbacan.com

SASQUATCH INN  
46001 LOUGHEED, HARRISON MILLS

GROUND FLOOR - PLAN VIEW

DATE: 03/12/09  
DRAWN: KL


CL-1.17

# PARKING LOT



# Brewmaster's Dinner

Black mark indicates two 20'x20' tents, they will be attached. The tent will have barricades around it for the event to ensure that no patrons veer outside the red line area. X marks the door we will be using. The tents in this plan will have security personnel to monitor that the patrons stay inside the proper area as well as the waitress.

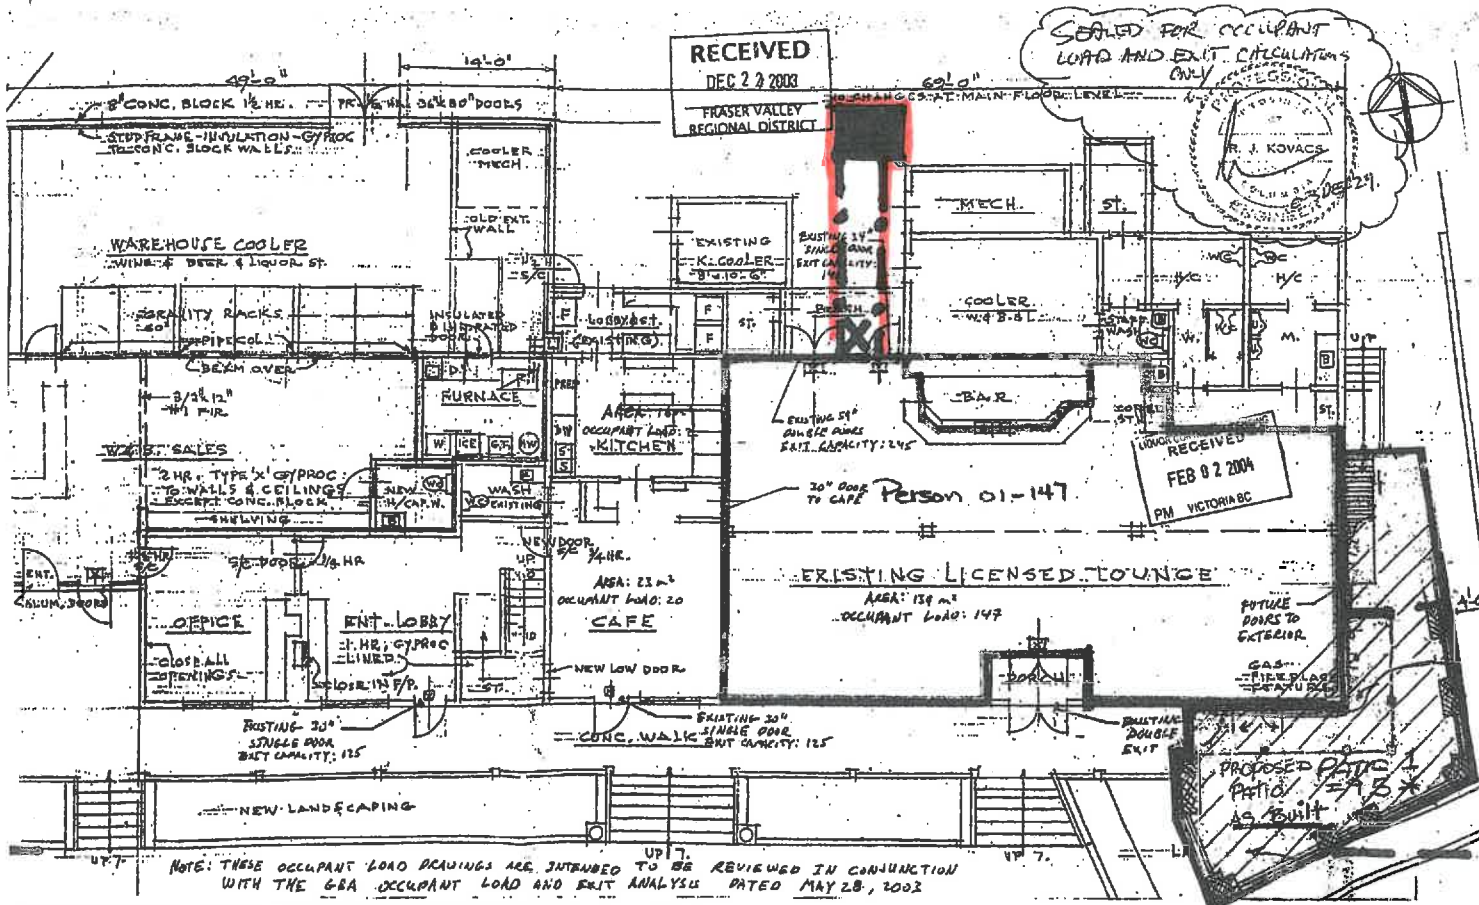

June 26, 2020

Occupant Load 30

Distance from Pub door to Tent is Appox 20'.

**GBA** GAGE-BASCOCK AND ASSOCIATES LTD  
228 - 105 W BROADWAY, VANCOUVER BC  
TEL: 732 3781 FAX: 732 1277  
email: info@gbacan.com, www.gbacan.com

SASQUATCH INN  
46001 LOUGHEED, HARRISON MILLS

GROUND FLOOR - PLAN VIEW

DATE: 03/12/09  
DRAWN: KL

# PARKING LOT

# DEVELOPMENT PERMIT 2002-11 SCHEDULE "B" Site Plan


## SHOW & SHINE

July 26, 2020

SURVEY CERTIFICATE OF P.I.D. 026-776-937  
LS 2, SEC 34, TP 3, R 30,  
HGM, NWD, PLAN 67884

CIVIC ADDRESS  
46001 LOUGHEED HIGHWAY,  
HARRISON HILLS, B.C.

SCALE 1:400  
DIMENSIONS SHOWN ARE IN METERS.

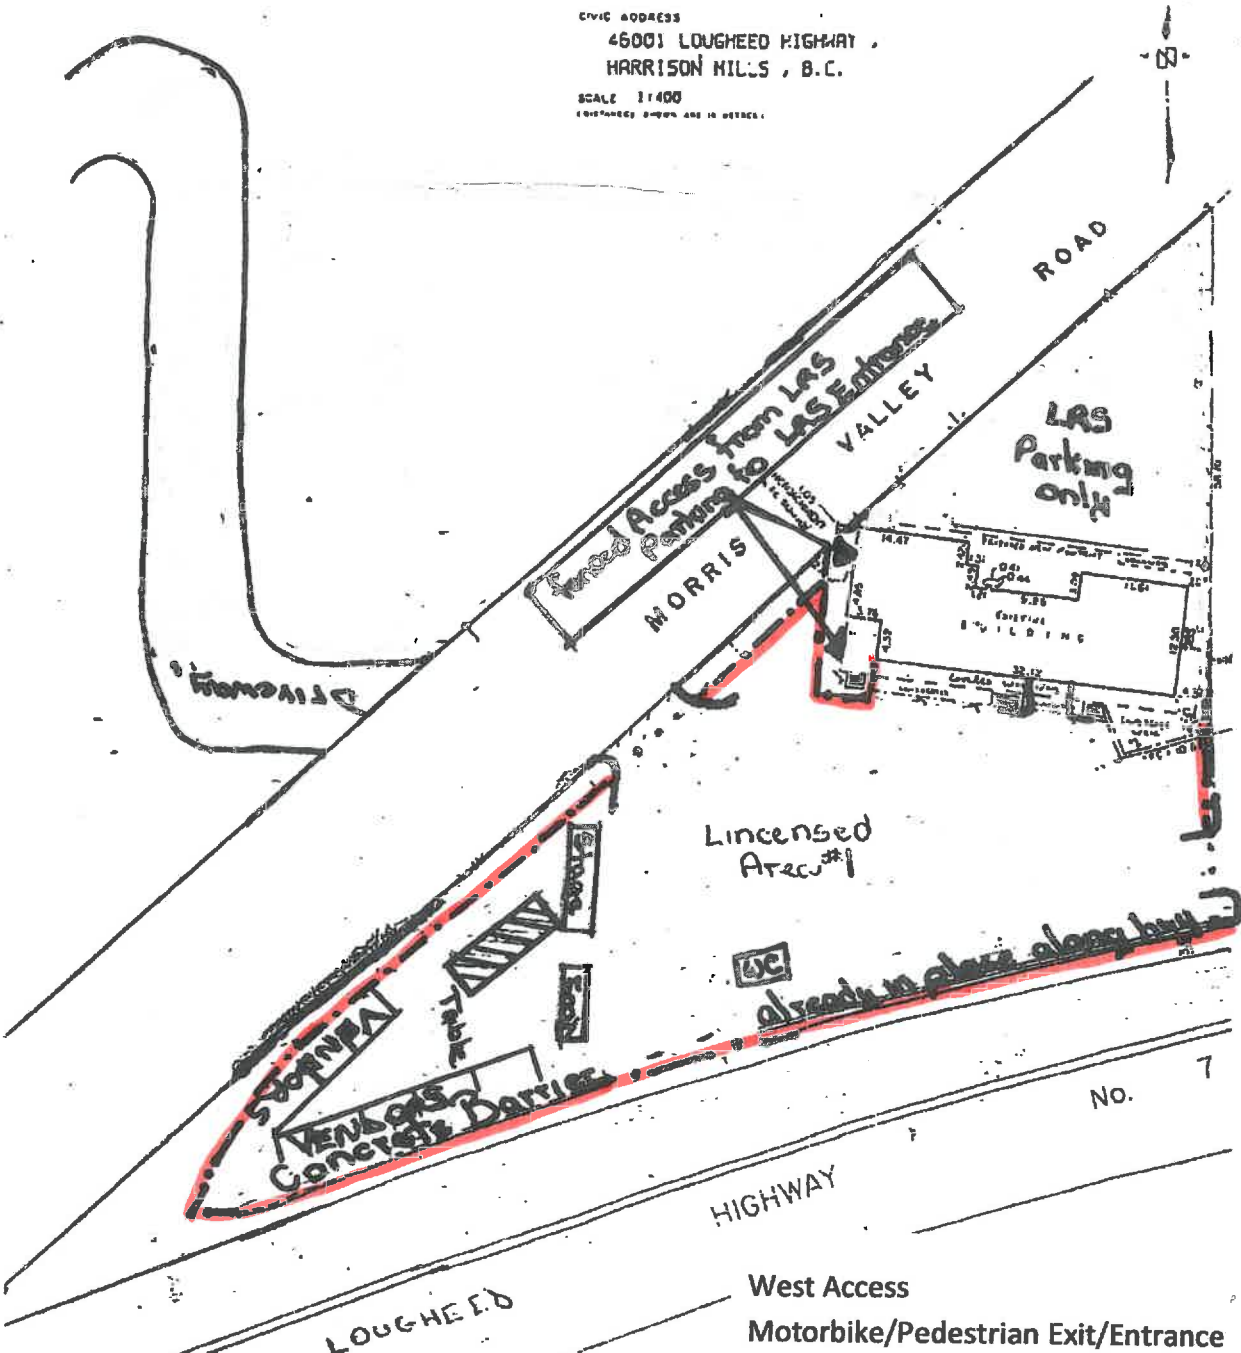

### LEGEND


	Bar- (alcohol service)
	Fencing
	Entrance
	Washroom

L:\PLANDocs\DP2002-11\ShowPermit.dwg  
Fencing will be Festival Fencing.

East Access  
Motorbike Exit Only  
Pedestrian Exit/Entrance

# Wespac Electrical

Black mark indicates two 20'x20' tents, they will be attached. The tent will have barricades around it for the event to ensure that no patrons veer outside the red line area. X marks the door we will be using. The tents in this plan will have security personel to monitor that the patrons stay inside the proper area as well as the waitress.

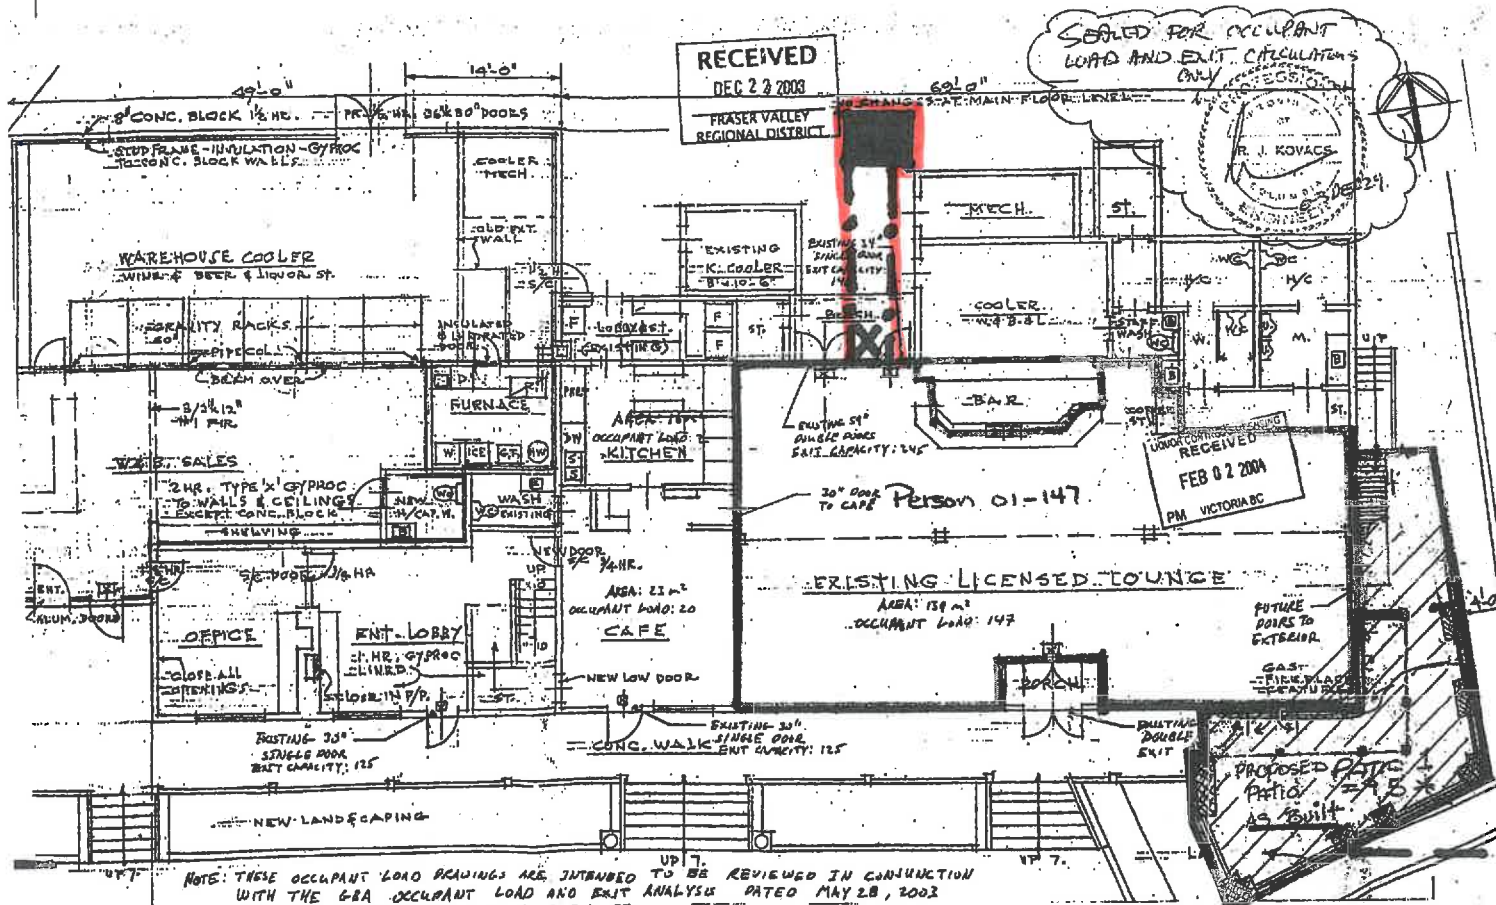

Sept. 12, 2020

Occupant Load 40

Distance from Pub door to Tent is Appox 20'.

**GBA** GAGE-BARCOCK AND ASSOCIATES LTD  
228 - 126 W. BROADWAY, VANCOUVER BC  
TEL: 772 5781 FAX: 772 1277  
email: info@gbacan.com, www.gbacan.com

SASQUATCH INN  
46001 LOUGHEED, HARRISON MILLS

GROUND FLOOR - PLAN VIEW  
DATE: 03/12/09  
DRAWN: KL

# PARKING LOT



**KHRONOS**  
SECURITY SERVICES

**Khronos Security Services**  
*www.khronossecurity.ca*  
665 Hudson Bay Street

Hope, BC, V0X 1L0 (604) 869-6535

To whom it may concern:

This is to confirm that Khronos Security agrees to provide security on the 26<sup>th</sup> of July 2020, at the 15<sup>th</sup> Annual Motorcycle Show & Shine at the Sasquatch Inn, located at 46001 Lougheed Hwy, Harrison Mills, BC.

We will be supplying 5 guards from 12 – 6pm. They will be located at the following locations:

One at the East entrance (This is a pedestrian exit/entrance, and a bike exit only)  
One at the West entrance (This is a bike and pedestrian exit/entrance)  
One at the entrance to the pub  
One at the entrance to the liquor store  
One roaming.

Khronos Security will ensure the following:

- ID is checked at all entrances to ensure that all attendees are 19 yrs of age
- Minors are not permitted
- Counts for attendees are to be completed every 30 mins. A written record of the head counts will be kept.
- Ensure no liquor enters or leaves the licensed area.
- Refuse entry to anyone appearing intoxicated.

Sincerely,

Zac Wells