

MAR 04 2020



Liquor and Cannabis Regulation Branch
 400-645 Tyeer Road, Victoria, BC V9A 6X5
 Mail: PO Box 9292 Stn Provincial Govt, Victoria, BC V8W 9J8
 Phone: 1 866 209-2111 Fax: 250-952-7066

TEMPORARY CHANGE TO A LIQUOR LICENCE FOOD PRIMARY, LIQUOR PRIMARY, LIQUOR PRIMARY CLUBS & MANUFACTURERS ENDORSEMENTS

Liquor and Cannabis Regulation Form LCRB023

Instructions:

Complete all applicable fields and then submit with payment as outlined in Part 11 of this application form. You may complete this form online and then print. If you have any questions about this application, call the Liquor and Cannabis Regulation Branch (LCRB) toll-free at: 1 866 209-2111. A complete application including the supporting documents must be submitted a minimum of three (3) weeks in advance of your event(s); otherwise your application will not be accepted and will returned to you with the fees.

Applications requesting discretion to policy (see Part 9) must be submitted a minimum of two (2) months prior to your proposed event; otherwise your application will not be accepted and will be returned to you with the fees. LCRB forms and supporting materials referred to in this document can be found at: www.gov.bc.ca/liquorregulationandlicensing

Licensee Information

Office use only

Licence number: 136311

Job No. (C3-LIC) MAR 04 2020

Type: Food Primary Liquor Primary Liquor Primary Club Winery

Licencee name (as shown on licence): Sasquatch Inn Ltd

Establishment name (as shown on licence): Sasquatch Inn Ltd

Establishment Address: 46001 Lougheed Hwy Harrison Mills BC VOM 1L0
Street City Province Postal Code

Contact Name: Nancy Maclean Title/Position: Asst Manager
(last / first / middle)

Business Tel with area code: 604-796-2730 Business Fax with area code: 604-796-2911

Business e-mail: nancy@sasquatchinn@shaw.ca

Business Mail address (if different from above): Box 26 Harrison Mills BC VOM 1L0
Street City Province Postal Code

Note: An authorized signing authority of a licensee can appoint a representative to interact with the branch on their behalf by completing form LCRB101 Add, Change or Remove Licensee Representative

Part 1: Temporary Change Requested

Please check the appropriate boxes below. You may complete more than one change section on this form as long as the changes are for the same licence number. **Note:** Categories noted by an asterisk (*) require local government/First Nations comment.

Type of change requested	Complete Sections
<input type="checkbox"/> Temporary change to hours of sale • Liquor-Primary and Liquor-Primary Club licences, and manufacturer lounge or special event endorsements – any hours changes* • Food-Primary licences – requests for hours of sale later than midnight* • Food-Primary licences – requests for hours of sale before midnight	1, 2, 3, 10, 11, 12 1, 2, 3, 10, 11, 12 1, 2, 3, 10, 11
<input type="checkbox"/> Temporary patron participation entertainment endorsement* Food-Primary licences only	1, 2, 4, 10, 11, 12
<input type="checkbox"/> Temporary extension of licensed area Food-Primary licences only	1, 2, 5, 10, 11
<input checked="" type="checkbox"/> Temporary extension of licensed area* Liquor-Primary and Liquor-Primary Club licences, and manufacturer lounge or special event endorsements.	1, 2, 6, 10, 11, 12
<input type="checkbox"/> Temporary location change* Liquor-Primary and Liquor-Primary Club licences only (no increase in patron or person capacity)	1, 2, 7, 10, 11, 12
<input type="checkbox"/> Temporary location change Food-Primary licenses only (no increase in patron or person capacity)	1, 2, 8, 10, 11
<input type="checkbox"/> Other Applies to all change requests other than these listed above	1, 2, 9, 10, 11

Part 2: Reason Temporary Change is Requested

Describe event details including who is holding the event, the hours of the event and its purpose:

Craft Night
 Friday, July 10, 2020 6-10pm
 Hosted by Sasquatch Inn
 Current seating capacity is 144 See attachment - wish to make extended area licensed for 40

Wilson/Fenton Wedding
 Saturday, July 25, 2020 12pm-11pm
 Wedding and Reception to be hosted by Sasquatch Inn
 Current seating capacity is 144 See attachment - wish to make extended area licensed for 100

Craft Night
 Friday, September 25, 2020 6-10pm
 Hosted by Sasquatch Inn
 Current seating capacity is 144 See attachment - wish to make extended area licensed for 40

Craft Night
 Friday, October 16, 2020 6-10pm
 Hosted by Sasquatch Inn
 Current seating capacity is 144 See attachment - wish to make extended area licensed for 40

Date(s) from: (mm/dd/yy) To: (mm/dd/yy) (inclusive)

Part 3: Temporary Change to Hours of Sale

Fee: \$330

Liquor-Primary and Liquor-Primary Club licences, and manufacturer lounge or special event endorsements – any hours changes*

Fee: \$330

Food-Primary licences – requests for hours of sale later than midnight*

Fee: \$110

Food-Primary licences – requests for hours of sale before midnight (local government/First Nations comment not required)

***Note:** These categories (*) require local government/First Nation comment.

Licensees may apply for a temporary change in hours of sale for a limited period, subject to any restrictions within the Liquor Control and Licensing Act, Regulations, branch policies and/or original terms and conditions of licensing. See Part 12 for more information on obtaining local government/First Nations comment.

Please provide the following information:

Current hours of sale:

	Monday	Tuesday	Wednesday	Thursday	Friday	Saturday	Sunday
Open	<input type="text"/>						
Closed	<input type="text"/>						

Requested hours of sale: (Maximum hours permitted by regulation are between 9:00 am to 4:00 am of the same business day)

	Monday	Tuesday	Wednesday	Thursday	Friday	Saturday	Sunday
Open	<input type="text"/>						
Closed	<input type="text"/>						

Part 4: Temporary Patron Participation Entertainment Endorsement

Fee: \$330

(Food-Primary licences only)

Licensees may apply for a patron participation entertainment endorsement for a limited period, subject to any restrictions within the Liquor Control and Licensing Act, Regulations, branch policies and/or original terms and conditions of licensing.

Note: This application process requires comment from your local government/First Nation. See Part 12 for more information on this process.

Describe the type of entertainment you are requesting:

Patron participation must end by midnight unless approved by LCRB and local government/First Nations. There are restrictions related to forms of entertainment, sound systems, etc. If you are uncertain about any of the details of your proposal, please consult with licensing staff at LCRB in Victoria (see contact information in Part 11).

Part 5: Temporary Extension of Licensed Area (food-primary licences only)

Fee: \$110

This change enables licensees to apply for a temporary extension of their establishment's licensed areas for a limited period, subject to any restrictions within the *Liquor Control and Licensing Act*, Regulations, branch policies and/or original terms and conditions of licensing. Approval of this temporary change request permits the licensee to operate only at the capacity on the face of their current licence plus the capacity of the extension area. If in doubt, consult with licensing staff at LCRB in Victoria (see Part 11 for contact info). This application process does not require comment from your local government/First Nation.

Please provide the following information and documents:

- Current total capacity, including patios (as shown on licence);
- Identify the area (person/patron as shown on licence) to be extended;
- Floor plan of the extended area showing how perimeter is defined, dimensions and its physical relationship to existing licensed areas:
 - Floor plan must have occupant load of the extended area marked/stamped on the plans by provincial fire or building authority (or designate) where the extension is indoors or within a permanent structure.
 - Provide proposed capacity of extended area if extension is outside; and
- Where the extension area is not on property owned or controlled by the licensee, provide written approval for such use from the property owner.

Part 6: Temporary Extension of Licensed Area

Fee: \$330

(liquor-primary, liquor-primary club licence and manufacturer lounge and special events endorsements only)

Licensees may apply for a temporary extension of their licensed areas for a limited period, subject to any restrictions within the *Liquor Control and Licensing Act*, Regulations, branch policies and /or original terms and conditions of licensing. Approval of this temporary change request permits the licensee to operate at the capacity on the face of their current licence plus the capacity of the extension area.

Note: This application process requires comment from your local government/First Nation. See Part 12 for more information on this process.

Please provide the following information and documents:

- Current total capacity, including patios (as shown on licence);
- Identify the area(s) to be extended;
- Floor plan of the extended area(s) showing how perimeter is defined, dimensions and its physical relationship to existing licensed areas:
 - Floor plan must have occupant load of the extended area marked/stamped on the plans by provincial fire or building authority (or designate) where the extension is indoors or within a permanent structure.
 - Provide proposed person capacity of extended area(s) if extension is outside; and
- Where the proposed area is not on property owned or controlled by the licensee, provide written approval for such use from the property owner.

Part 7: Temporary Location Change (liquor-primary and liquor-primary club licences only)

Fee: \$330

(no increase in patron or person capacity)

Licenses may apply for a temporary change of location of one or more licensed areas in their establishment, to accommodate special events but this change permits no increase in licensed capacity. Proposed changes must comply with occupant load limitations.

Note: This application process requires comment from your local government/First Nation. See Part 12 for more information on this process.

Current area capacities, as shown on licence:

Area #1 Area #2 Area #3 Area #4 Patio #1 Patio #2

Proposed temporary changes in capacity (no increase in total capacity permitted):

Area #1 Area #2 Area #3 Area #4 Patio #1 Patio #2

Please attach the following documents:

- Floor plan of the proposed area(s) showing how perimeter is defined, dimensions and its physical relationship to existing licensed areas.
 - Floor plan must have occupant load marked/stamped on the plans by provincial fire or building authority (or designate), where the extension is indoors or within a permanent structure.
 - Provide proposed capacity of the new area if outdoors.
- Where the proposed area is not on property owned or controlled by the licensee, provide written approval for such use from the property owner.

Part 8: Temporary Location Change (food-primary licences only)

Fee: \$110

(no increase in patron or person capacity)

Licenses may apply for a temporary change of location of one or more licensed areas in their establishment, to accommodate special events but this change permits no increase in licensed capacity. Proposed changes must comply with occupant load limitations.

Note: This application process does not require comment from your local government/First Nation.

Current area capacities, as shown on licence:

Area #1 Area #2 Area #3 Area #4 Interior lounge
Patio #1 Patio #2

Proposed temporary changes in capacity (no increase in total capacity permitted):

Area #1 Area #2 Area #3 Area #4 Interior lounge
Patio #1 Patio #2

Please attach the following documents:

For food-primary licences:

- Floor plan of the proposed area showing how perimeter is defined, dimensions and its physical relationship to existing licensed areas.
 - Floor plan must have occupant load marked/stamped on the plans by provincial building or fire authority (or designate), where the extension is indoors or within a permanent structure.
 - Provide proposed capacity of the new area if outdoors.
- Where the proposed area is not on property owned or controlled by the licensee, provide written approval for such use from the property owner.

Part 9: Other

Complete this section if you are requesting a change other than those listed in Part 1, page 1. Describe your request in detail, using additional pages if required.


If your request requires an exercise of discretion: provide a written submission detailing why a request for discretion should be approved. All documentation to support your request for discretion must be submitted together in one package; the branch will not consider additional materials submitted after a completed application is received. For more information see your licence specific terms and conditions. Requests for discretion should be submitted at least two months prior to the proposed event.

Date(s) from: (mm/dd/yy) To: (mm/dd/yy) (inclusive) Time(s):

Part 10: Declaration

Section 57(1)(c) of the *Liquor Control and Licensing Act* states: "A person commits an offence if the person (c) provides false or misleading information in the following circumstances: (i) when making an application referred to in section 12; (ii) when making a report or when required and as specified by the general manager under section 59".

As the licensee or authorized signatory of the licensee, I understand and affirm that all of the information provided is true and complete.

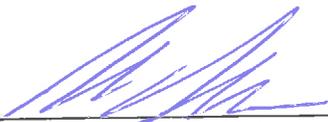Signature:  _____
Authorized signatory of the licensee

Name: (last / first / middle) Position: (if not an individual) Date: (Day/Month/Year)

Note: An agent, lawyer or third party operator may not sign the declaration on behalf of the licensee. This form should be signed by an individual with the authority to bind the applicant. The Branch relies on the licensee to ensure that the individual who signs this form is authorized to do so. Typically, an appropriate individual will be as follows:
• If the licensee is an individual or sole proprietor, the individual himself/herself
• If the licensee is a corporation, a duly authorized signatory who will usually be an officer or, in some cases, a director
• If the licensee is a general partnership, one of the partners
• If the licensee is a limited partnership, the general partner of the partnership
• If the licensee is a society, then a director or a senior manager (as defined in the *Societies Act*)

If an authorized signatory has completed the *Add, Change or Remove Licensee Representative* form (LCRB101) and they have specifically permitted a licensee representative to sign this form on the licensee's behalf, the branch will accept the licensee representative's signature.

Part 11: Application Fees - Payment Options Total Fee Submitted: \$

In accordance with Payment Card Industry Standards, the branch is no longer able to accept credit card information via email.

- Payment is by (check) one):
- Cheque, payable to Minister of Finance (if cheque is returned as non-sufficient funds, a \$30 fee will be charged)
 - Money order, payable to Minister of Finance
 - Credit card: VISA MasterCard AMEX
 - I am submitting my application by email and I will call with my credit card information. I will call Victoria Head Office at 250-952-5787 or 1-866-209-2111 and understand that no action can proceed with my application until the application fee is paid in full.
 - I am submitting my application by fax or mail and have given my credit information in the space provided at the bottom of the page.

Credit Card Information (To be submitted by fax or mail only)


Name of cardholder (as it appears on card):

Credit card number: Expiry date: /
(Month) (Year)

Signature: _____

Craft Night

Black mark indicates two 20'x20' tents, they will be attached. The tent will have barricades around it for the event to ensure that no patrons veer outside the red line area. X marks the door we will be using. The tents in this plan will have security personel to monitor that the patrons stay inside the proper area as well as the waitress.

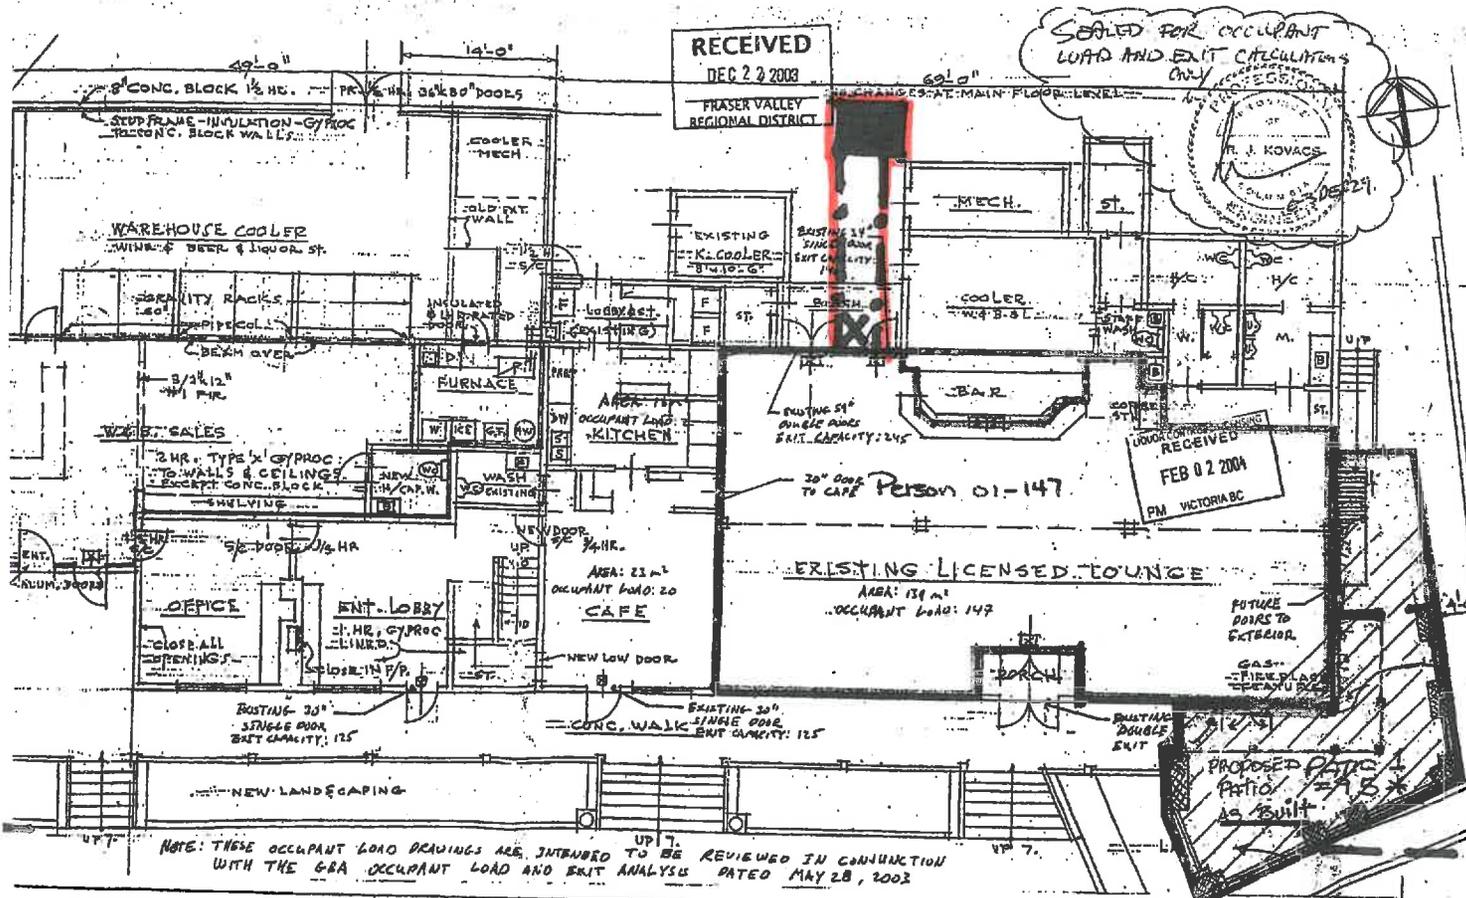

July 10, 2020

Occupant Load 40

Distance from Pub door to Tent is Appox 20'.

GBA
GAGE-BABCOCK AND ASSOCIATES LTD
228 - 186 W. BROADWAY, VANCOUVER BC
TEL: 732 9781 FAX: 732 2277
email: info@gbacan.com, www.gbacan.com

SASQUATCH INN
46001 LOUGHEED, HARRISON MILLS


GROUND FLOOR - PLAN VIEW

DATE: 03/12/09
DRAWN: KL

PARKING LOT

Wilson/Fenton Wedding

Black mark indicates two tents (30' x 20', 20' x 20'), they will be attached. The tents will have barricades around it for the event to ensure that no patrons veer outside the red line area. X marks the door we will be using. The tents in this plan will have security personnel to monitor that the patrons stay inside the proper area as well as the waitress.

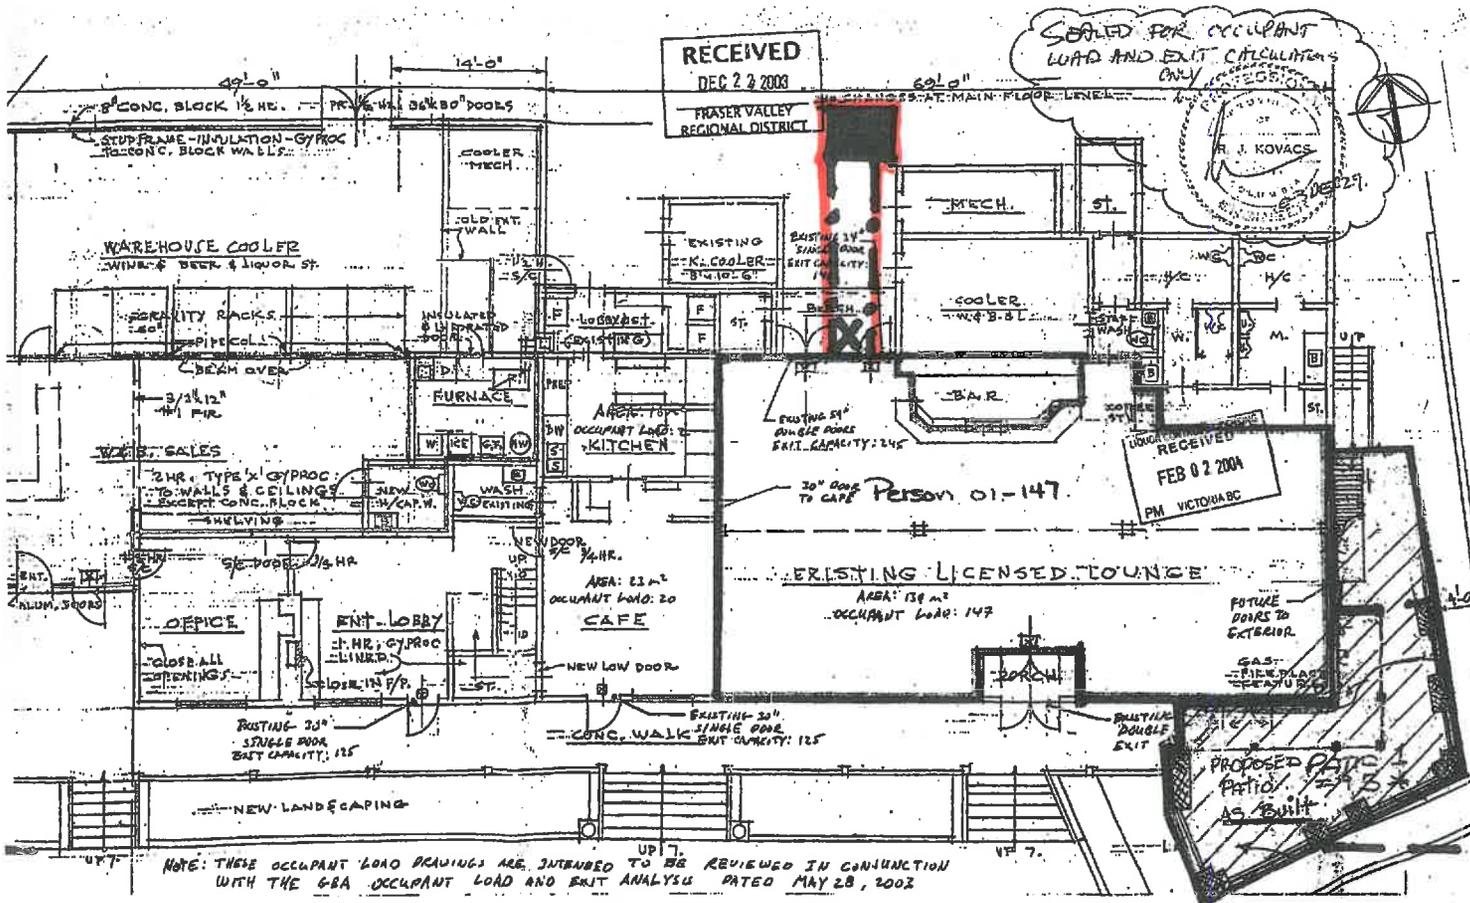

July 25, 2020

Occupant Load 100

Distance from Pub door to Tent is Appox 20'.

NOTE: THESE OCCUPANT LOAD DRAWINGS ARE INTENDED TO BE REVIEWED IN CONJUNCTION WITH THE GBA OCCUPANT LOAD AND EXIT ANALYSIS DATED MAY 28, 2002

GBA GAGE-SABCOCK AND ASSOCIATES LTD
228 - 1048 W. BROADWAY, VANCOUVER BC
TEL 732 3731 FAX 732 1277
email: info@gsa.com, www.gsa.com

SASQUATCH INN
46001 LOUGHEED, HARRISON MILLS


GROUND FLOOR - PLAN VIEW

DATE: 03/12/09
DRAWN: KL

PARKING LOT

Craft Night

Black mark indicates two 20'x20' tents, they will be attached. The tent will have barricades around it for the event to ensure that no patrons veer outside the red line area. X marks the door we will be using. The tents in this plan will have security personnel to monitor that the patrons stay inside the proper area as well as the waitress.

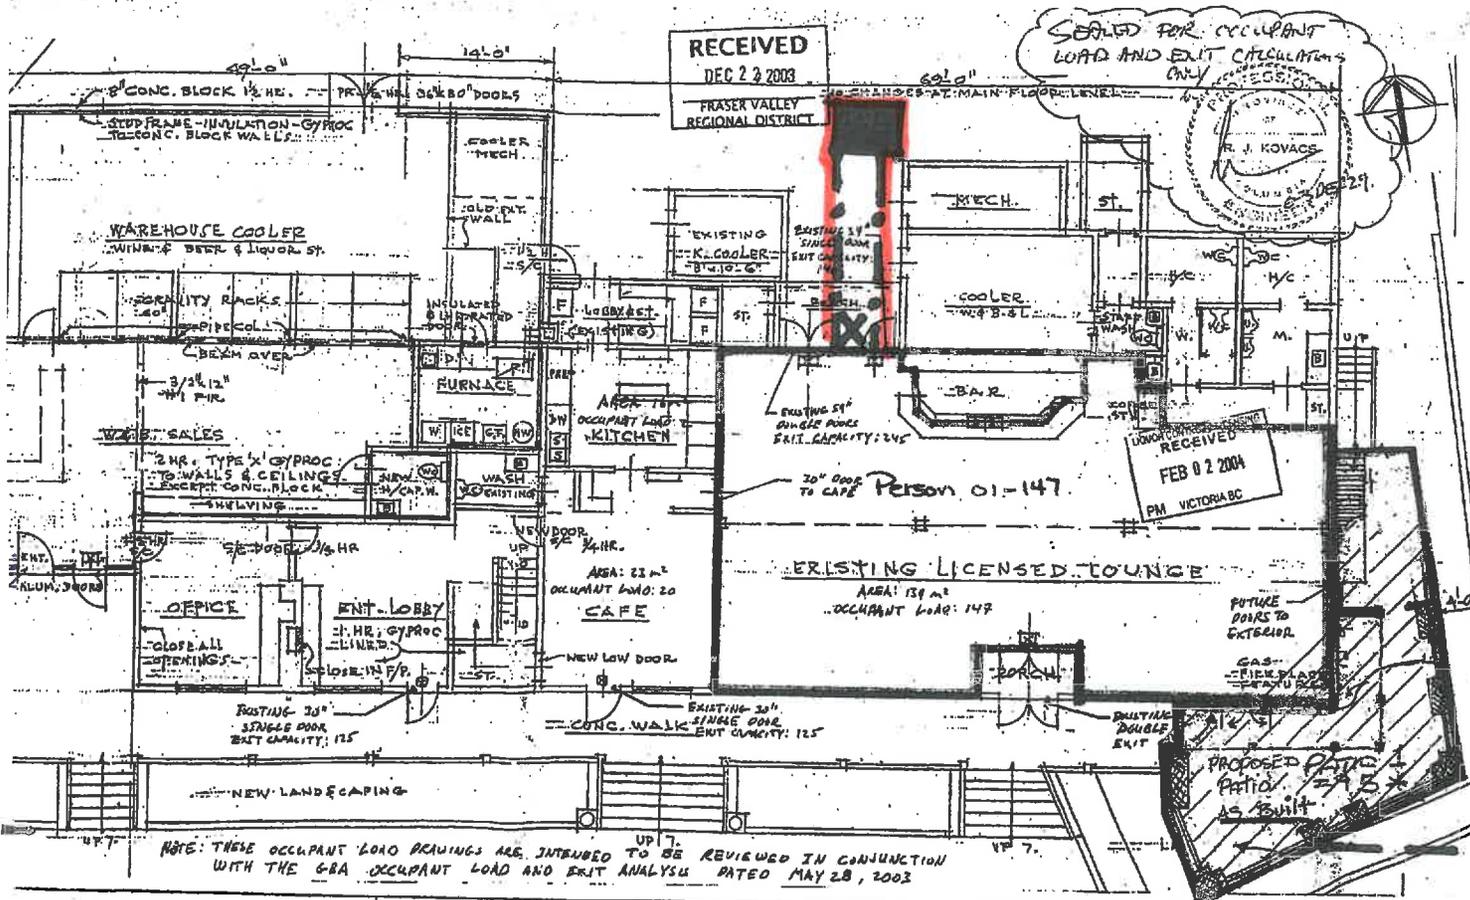

September 25, 2020

Occupant Load 40

Distance from Pub door to Tent is Appox 20'.

G&A
GAGE-BASCOCK AND ASSOCIATES LTD
228 - 104 W. BROADWAY, VANCOUVER BC
TEL: 778 878 FAX: 772 1277
email: hodge@gbacorp.com, www.gbacorp.com

SASQUATCH INN
46001 LOUGHEED, HARRISON MILLS


GROUND FLOOR - PLAN VIEW

DATE: 03/12/09
DRAWN: KL

PARKING LOT

Craft Night

Black mark indicates two 20'x20' tents, they will be attached. The tent will have barricades around it for the event to ensure that no patrons veer outside the red line area. X marks the door we will be using. The tents in this plan will have security personel to monitor that the patrons stay inside the proper area as well as the waitress.

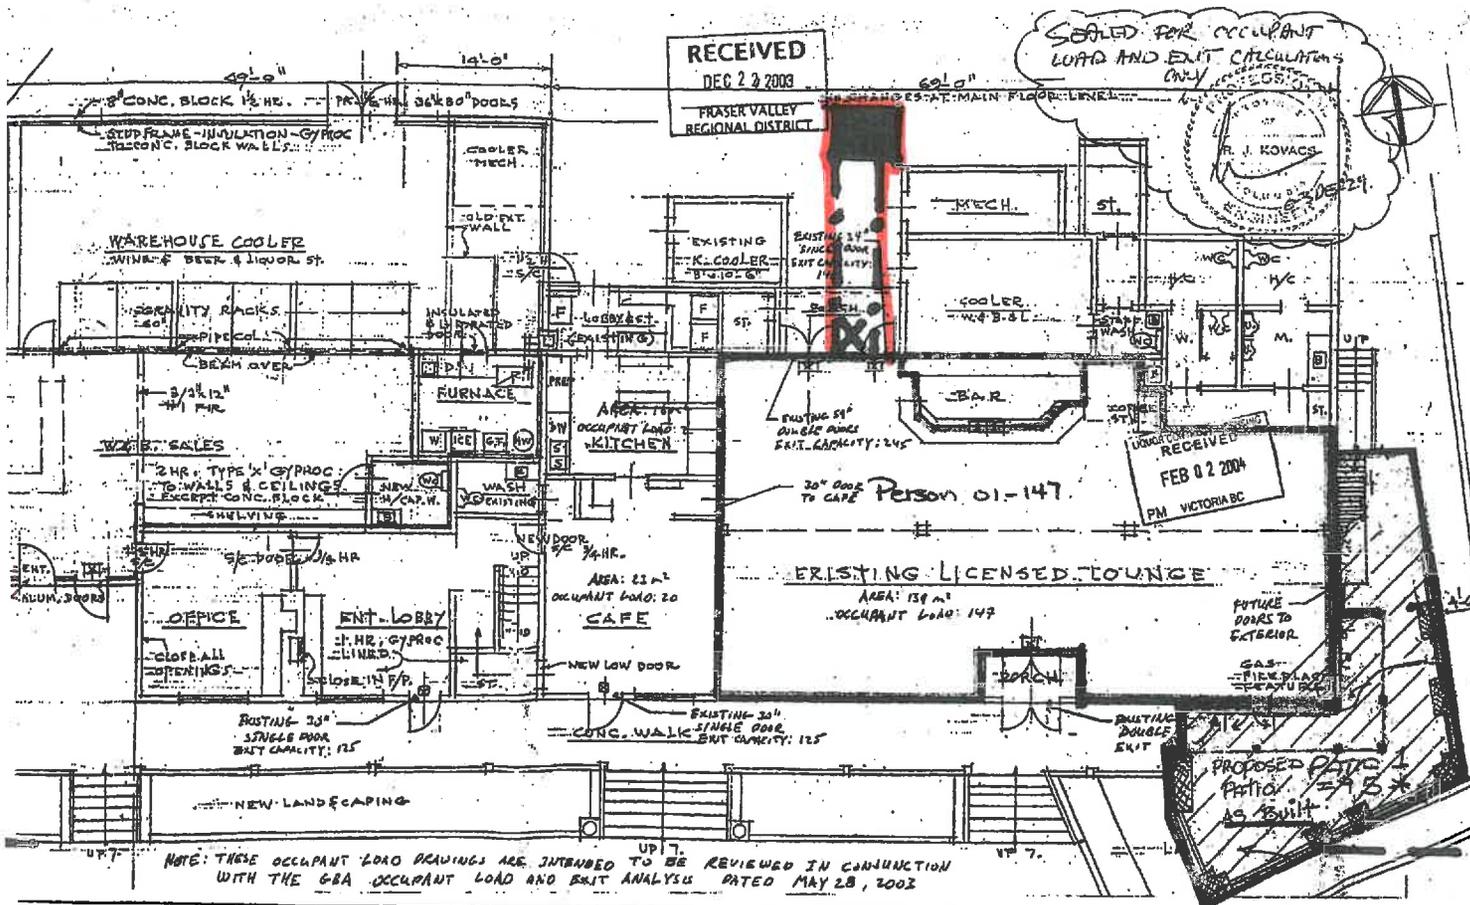

October 16, 2020

Occupant Load 40

Distance from Pub door to Tent is Approx 20'.

GBA GAGE-BABCOCK AND ASSOCIATES LTD
225 - 105 W. BROADWAY, VANCOUVER BC
TEL: 778-3781 FAX: 778-1277
email: info@gbacan.com, www.gbacan.com

SASQUATCH INN
46001 LOUGHEED, HARRISON MILLS

GROUND FLOOR - PLAN VIEW

DATE: 03/12/09
DRAWN: KL

CK.1.17

PARKING LOT