www.fvrd.ca | planning@fvrd.ca

SCHEDULE A-4 Permit Application I / We hereby apply under Part 14 of the Local Government Act for a; **Development Variance Permit Temporary Use Permit Development Permit** An Application Fee in the amount of \$_____ as stipulated in FVRD Application Fees Bylaw No. 1231, 2013 must be paid upon submission of this application. Civic Address PID _____ Lot_____Block____Section____Township_____Range____ Legal Description LOT 7 DISTRICT LOT 5671 GROUP 1 NEW WESTMINSTER DISTRICT PLAN 65552 The property described above is the subject of this application and is referred to herein as the 'subject property.' This application is made with my full knowledge and consent. I declare that the information submitted in support of the application is true and correct in all respects. Owner's Name of Owner (print) Signature of Owner Date Declaration Name of Owner (print) Date Owner's Contact Information

| Office Use Only | Date | File No. |
|--------------------|-------------|---------------|
| Omy | Received By | Folio No. |
| | Receipt No. | |
| | | Fees Paid: \$ |

Phone: 604-702-5000 | Toll Free: 1-800-528-0061 | Fax: 604-792-9684

| Agent | I hereby giv | e permission to | | to act as m | ny/our agent in | all matter | s relating to this | |
|--|---------------|---------------------------|------------------|----------------|------------------|-------------|------------------------|--------------|
| | application | • | | | | | | |
| Only complete this s the applicant is | ection if | Signature of Owner | | | Date | | | |
| NOT the owner. | | Signature of Owner | | | Date | | | |
| | | | | | - | | | |
| Agent's contact information and | | Name of Agent | | | Company | | | |
| declaration | | Address | | | | City | | |
| | | Email | | | | Post | al Code | |
| | | Phone | Cell | | | Fax | | |
| | | I declare that the inform | mation submitted | l in support o | of this applicat | ion is true | and correct in all | respects. |
| | | Signature of Agent | | | | | Date | |
| Development I | Details | | | | | | | |
| Property Size | | Present 2 | Zoning | | | | | |
| Existing Use | | | | | | | | |
| Proposed Develo | pment | | | | | | | |
| Proposed Variatio | on / Supple | ment | | | | | | |
| ' | | | | | | | | |
| | | | | | | | | |
| | | | | | | | | |
| | | | | | | | (use separate sheet if | f necessary) |
| Reasons in Suppo | ort of Applio | cation | | | | | | |
| | | | | | | | | |
| | | | | | | | | |
| | | | | | | | | |

Page 2 of 4

Riparian Areas Regulation

Please indicate whether the development proposal involves residential, commercial, or including vegetation removal or alteration; soil disturbance; construction of buildings and structures; creation of impervious or semi-pervious surfaces; trails, roads, docks, wharves, bridges and, infrastructure and works of any kind – within:

| yes | no | 30 metres of the high water mark of any water body |
|-----|----|--|
| yes | no | |
| | | a ravine or within 30 metres of the top of a ravine bank |

"Water body" includes; 1) a watercourse, whether it usually contains water or not; 2) a pond, , lake, river, creek, or brook; 3) a ditch, spring, or wetland that is connected by surface flow to 1 or 2 above.

Under the *Riparian Areas Regulation* and the *Fish Protection Act*, a riparian area assessment report may be required before this application can be approved.

Contaminated Sites Profile

Pursuant to the *Environmental Management Act*, an applicant is required to submit a completed "Site Profile" for properties that are or were used for purposes indicated in Schedule 2 of the *Contaminated Sites Regulations*. Please indicate if:

| yes | no | |
|-----|----|--|
| | | the property has been used for commercial or industrial purposes |

If you responded 'yes,' you may be required to submit a Site Profile. Please contact FVRD Planning or the Ministry of Environment for further information.

Archaeological Resources

Are there archaeological sites or resources on the subject property?

| yes | no | I don't knov |
|-----|----|--------------|
| | | |

If you responded 'yes' or 'I don't know' you may be advised to contact the Archaeology Branch of the Ministry of Tourism, Sport and the Arts for further information.

Required Information

When providing Application Forms to the applicant, Regional District staff shall indicate which of the following attachments are required for this application. **Additional information may also be required at a later date.**

| | Required | Received | Details | |
|---------------------|----------|----------|--|--|
| Location Map | | | Showing the parcel (s) to which this application pertains and uses on | |
| - | | | adjacent parcels | |
| Site Plan | | | Reduced sets of metric plans | |
| | | | North arrow and scale | |
| At a scale of: | | | Dimensions of property lines, rights-of-ways, easements | |
| | | | Location and dimensions of existing buildings & setbacks to lot lines, | |
| 1: | | | rights-of-ways, easements | |
| | | | Location and dimensions of proposed buildings & setbacks to lot lines, rights-of-ways, easements | |
| | | | Location of all water features, including streams, wetlands, ponds, | |
| | | | ditches, lakes on or adjacent to the property | |
| | | | Location of all existing & proposed water lines, wells, septic fields, | |
| | | | sanitary sewer & storm drain, including sizes | |
| | | | Location, numbering & dimensions of all vehicle and bicycle parking, | |
| | | | disabled persons' parking, vehicle stops & loading | |
| | | | Natural & finished grades of site, at buildings & retaining walls | |
| | | | Location of existing & proposed access, pathways | |
| | | | Above ground services, equipment and exterior lighting details | |
| | | | Location & dimensions of free-standing signs | |
| | | | Storm water management infrastructure and impermeable surfaces | |
| | | | Other: | |
| Floor Plans | | | Uses of spaces & building dimensions | |
| | | | Other: | |
| Landscape | | | Location, quantity, size & species of existing & proposed plants, trees & | |
| Plan | | | turf | |
| | | | Contour information (metre contour intervals) | |
| Same scale | | | Major topographical features (water course, rocks, etc.) | |
| as site plan | | | All screening, paving, retaining walls & other details | |
| | | | Traffic circulation (pedestrian, automobile, etc.) | |
| | | | Other: | |
| Reports | | | Geotechnical Report | |
| | | | Environmental Assessment | |
| | | | Archaeological Assessment | |
| | | | Other: | |

The personal information on this form is being collected in accordance with Section 26 of the *Freedom of Information and Protection of Privacy Act, RSBC 1996 Ch. 165* and the *Local Government Act, RSBC 2015 Ch. 1.* It will only be collected, used and disclosed for the purpose of administering matters with respect to planning, land use management and related services delivered, or proposed to be delivered, by the FVRD. Questions about the use of personal information and the protection of privacy may be directed to the FVRD Privacy Officer at 45950 Cheam Avenue, Chilliwack, BC V2P 1N6, Tel: 1-800-528-0061 FOl@fvrd.ca.

SUBDIVISION PLAN OF D.L. 5671, GP. 1, N.W.D.

TRACKER SURVEY SERVICES 6775 Lorne Drive Sardis B.C. V2R 2G3

JUN 0 5 2018

UNORGANIZED TERRITORY AT HEMLOCK VALLEY, B.C.

1:1000 RED 60 1:2000 SCALE DISTANCES ARE SHOWN IN METRES


LEGEND

BEARINGS ARE ASTRONOMIC DERIVED FROM PLAN 58157

- DENOTES IRON POST FOUND
- DENOTES IRON POST SET
- OCIP DENOTES CAPPED IRON POST FOUND

LOT BEARINGS ARE RADIAL EXCEPT WHERE OTHERWISE NOTED


I, DAVID V. TREVORROW, A BRITISH COLUMBIA LAND SURVEYOR OF CHILLIWACK IN BRITISH COLUMBIA, CERTIFY THAT I WAS PRESENT AT AND DID PERSONALLY SUPERINTEND THE SURVEY REPRESENTED BY THIS PLAN AND THAT THE SURVEY AND PLAN ARE CORRECT. THE SAID SURVEY WAS COMPLETED ON THE 6th DAY OF OCTOBER 1982.

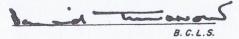



LAND CROWN 087° 25' 35 UNSURVEYED DIP 45.735 DIP 24.735 0.0668 0.0846 ha. DIP IP 21.000 IP 17.024 50, 0.0846 087° IP 21.066 35.D12 ROAD 19.664 0.0713 ha. 32,000 099°00'46 30 LOCATED U 0.0654 965 ha. 35 n 0931 ha. 34 0. 1017 ha. 33 32 31

HEMLOCK VALLEY BECREATION LTD.

JUN 0 5 2018 TRACKER SURVEY SERVICES SUBDIVISION PLAN OF LAND 6775 Lorne Drive Sardis B.C. V2R 2G3 CROWN D.L. 5671, GP. 1, N.W.D. 087° 25 35 UNSURVEYED DIP 45.735 UNORGANIZED TERRITORY DIP 24.735 AT HEMLOCK VALLEY, B.C. 0.0668 1:1000 RED 60 1:2000 0.0846 ha. SCALE DIP IP 21.000 IP 17.024 50. 0.0846 DISTANCES ARE SHOWN IN METRES 087° LEGEND 35.D12 ROAD BEARINGS ARE ASTRONOMIC DERIVED FROM PLAN 58157 32.000 30 DENOTES IRON POST FOUND 099° 00' 46 DENOTES IRON POST SET U 0.0654 965 ha. OCIP DENOTES CAPPE House dimensions are in blue. All 1580 measurements are from eaves LOT BEARINGS ARE R. 35 (outermost projection) OTHERWISE NOTED . Set backs are in green I. DAVID V. TREVORROW, A BRITISH COLUMBIA LAND SURVEYOR OF CHILLIWACK IN BRITISH COLUMBIA, CERTIFY THAT I WAS PRESENT AT AND DID PERSONALLY SUPERINTEND THE SURVEY REPRESENTED BY THIS PLAN AND THAT THE SURVEY AND PLAN ARE CORRECT. THE SAID SURVEY WAS 33 COMPLETED ON THE 6th DAY OF OCTOBER 1982. 32 HEMLOCK VALLEY BECREATION LTD. 31

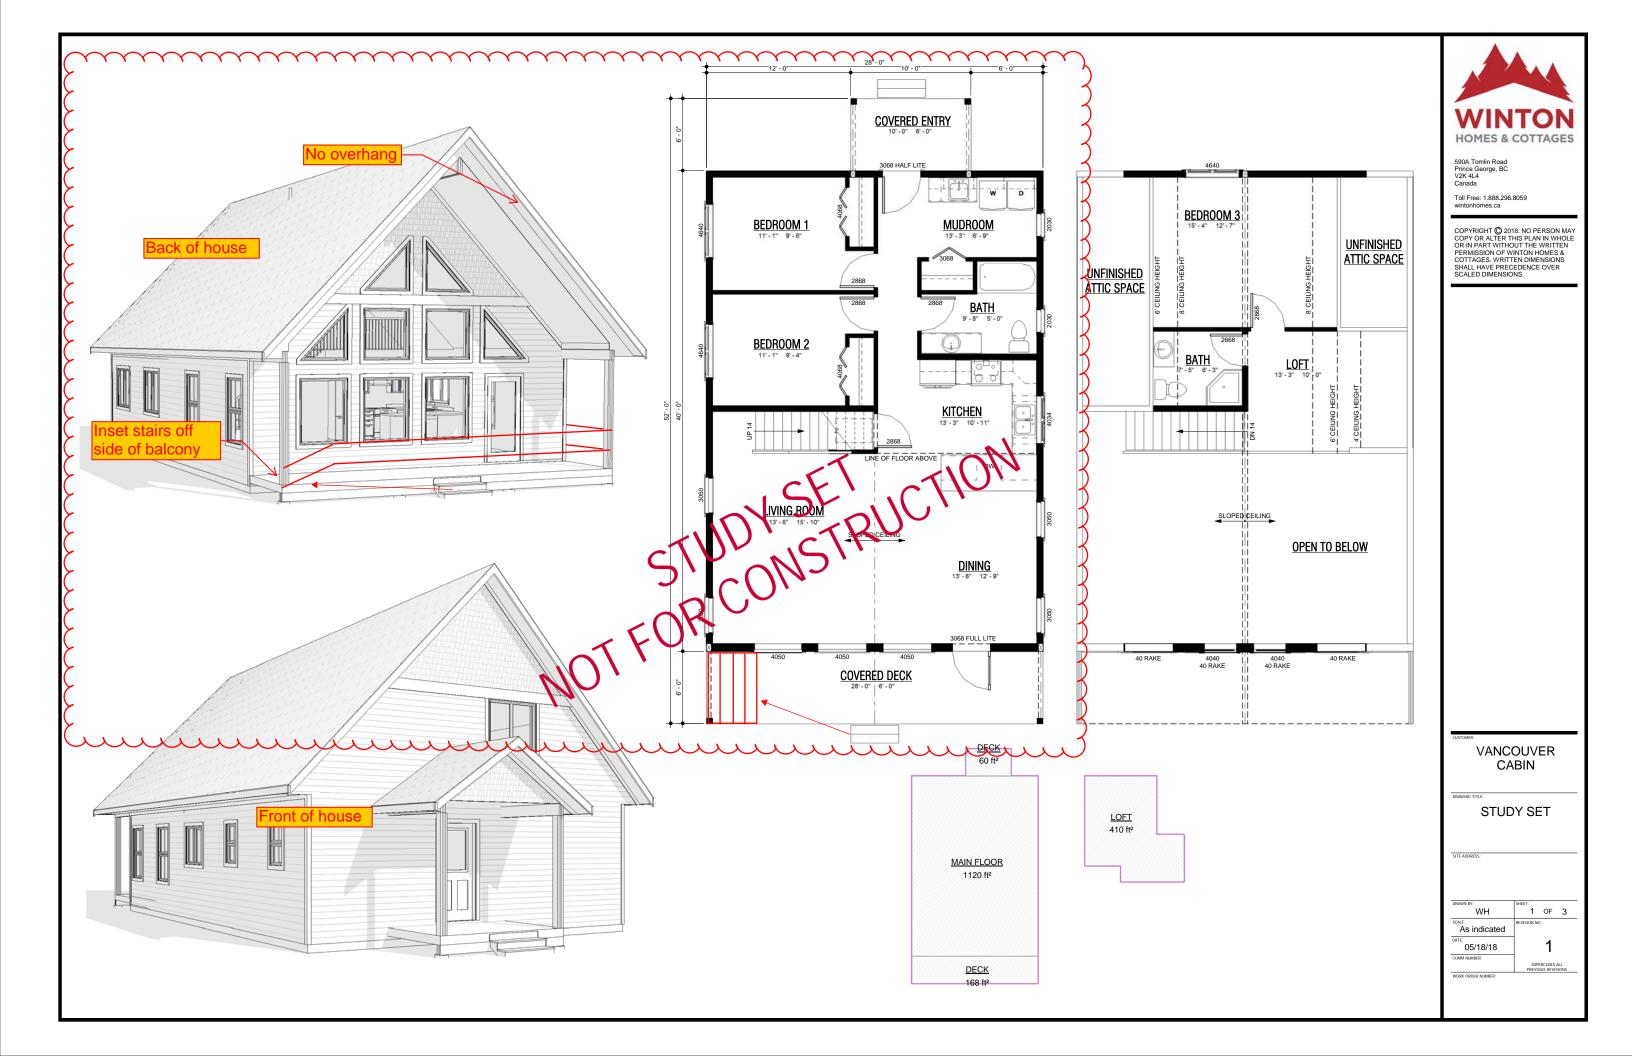

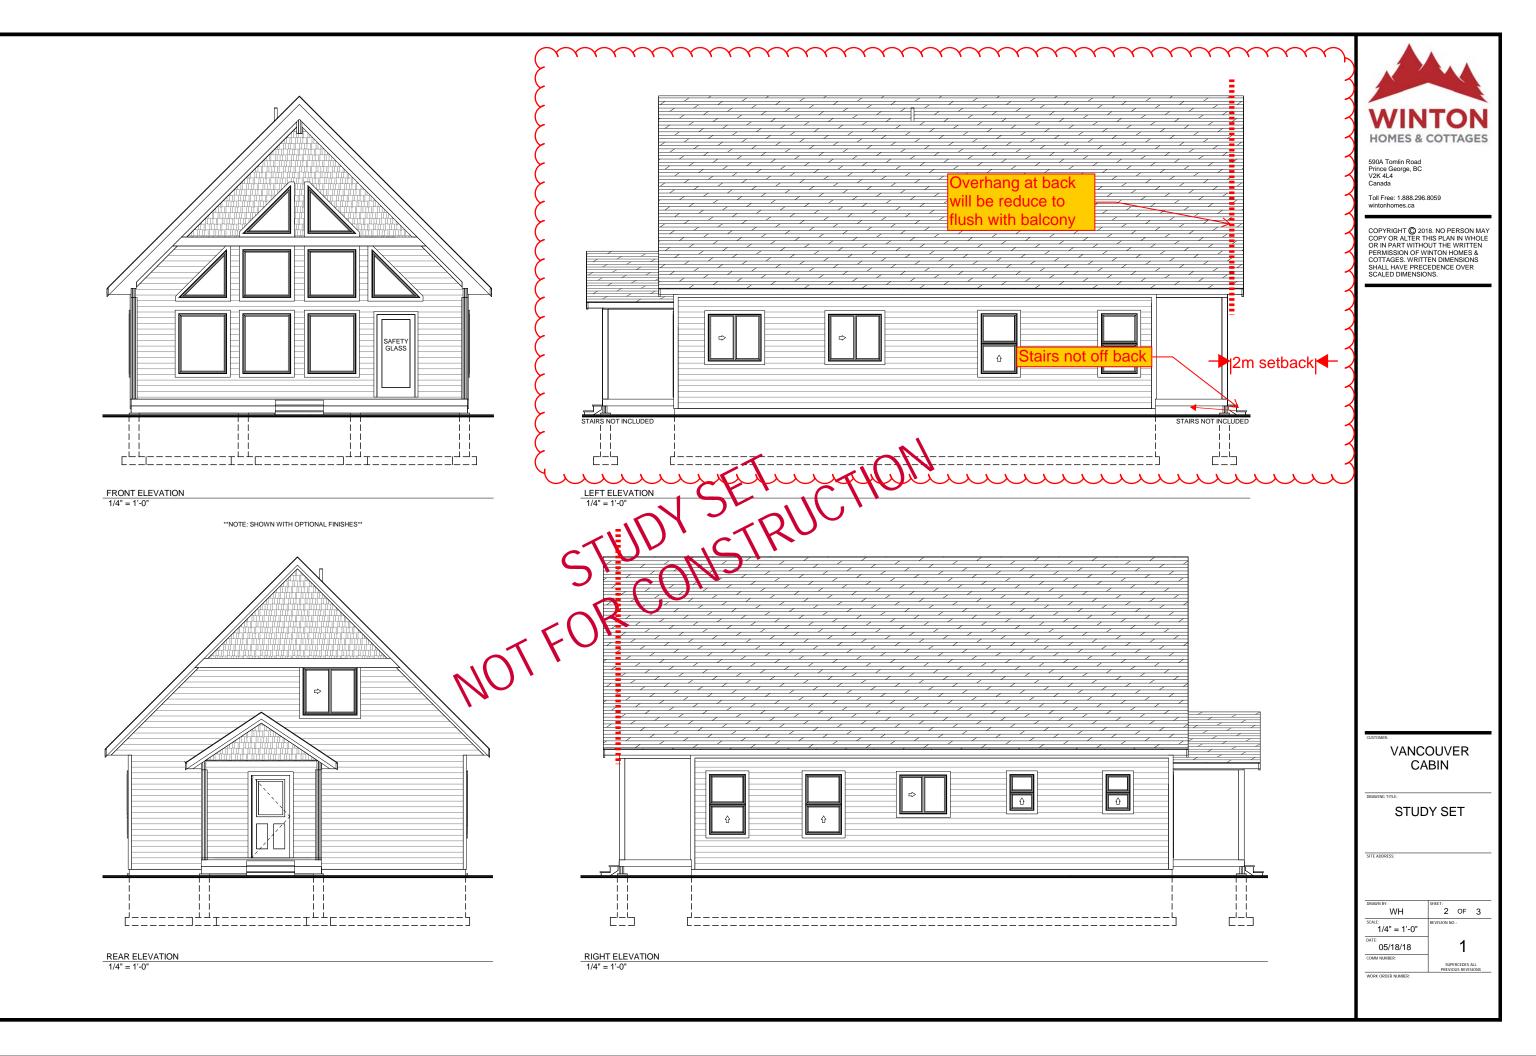

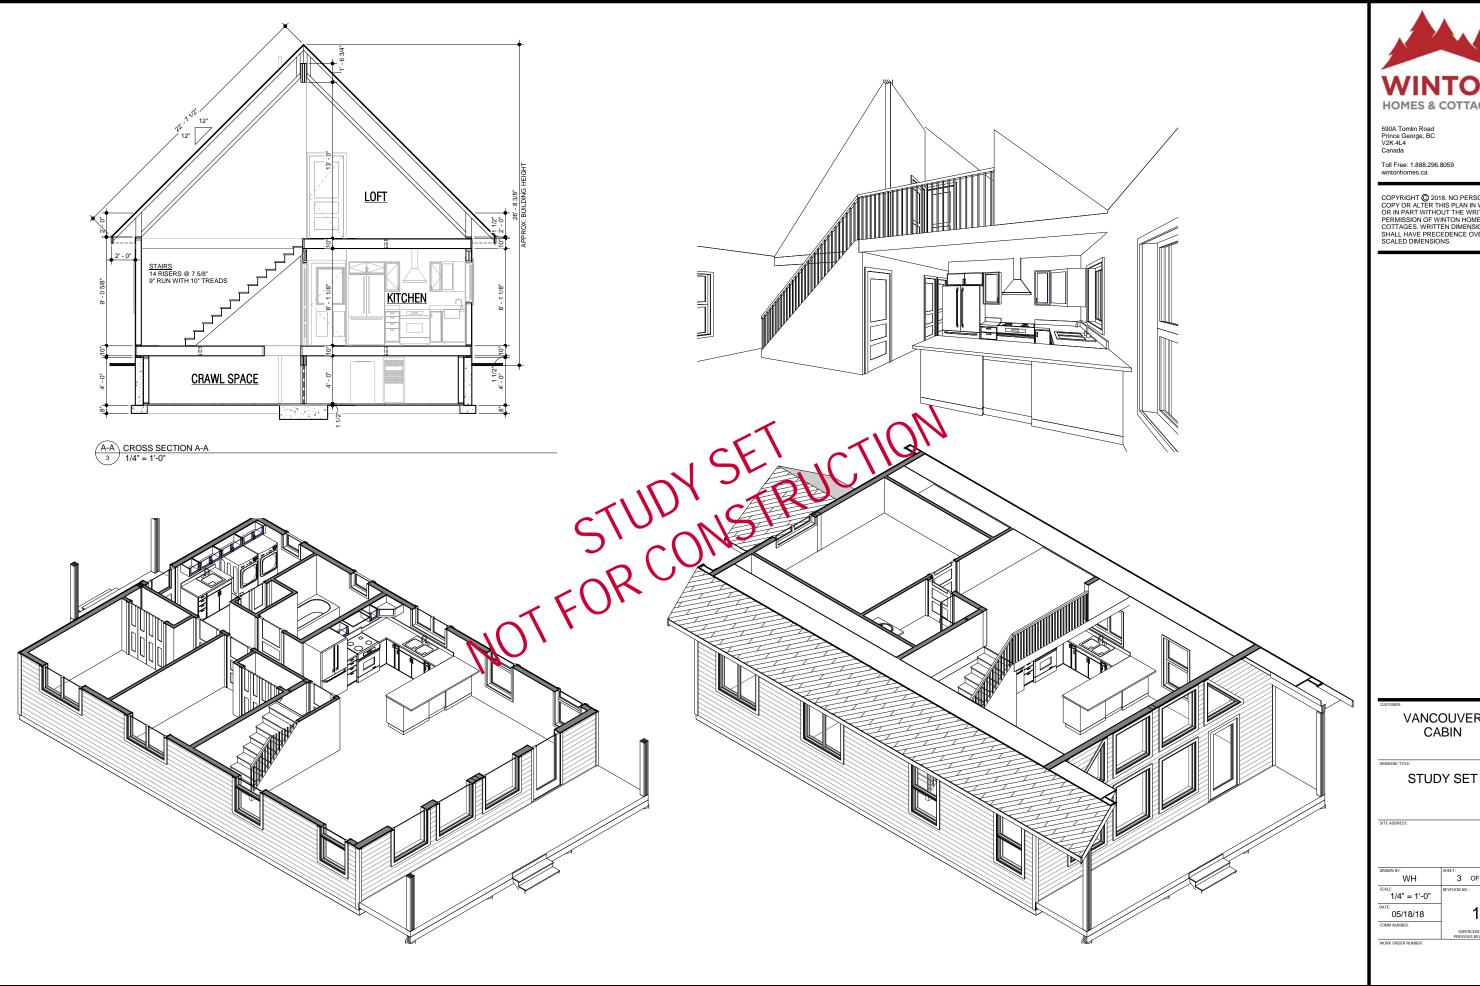



COPYRIGHT © 2018. NO PERSON MAY COPY OR ALTER THIS PLAN IN WHOLE OR IN PART WITHOUT THE WRITTEN PERMISSION OF WINTON HOMES & COTTAGES. WRITTEN DIMENSIONS SHALL HAVE PRECEDENCE OVER SCALED DIMENSIONS.

VANCOUVER CABIN

| DRAWN BY: | SHEET: |
|------------------------|--------------------------------------|
| WH | 3 OF 3 |
| SCALE: 1/4" = 1'-0" | REVISION NO.: |
| 05/18/18 | 1 |
| COMM NUMBER: | SUPERCEDES ALL PREVIOUS REVISIONS |